


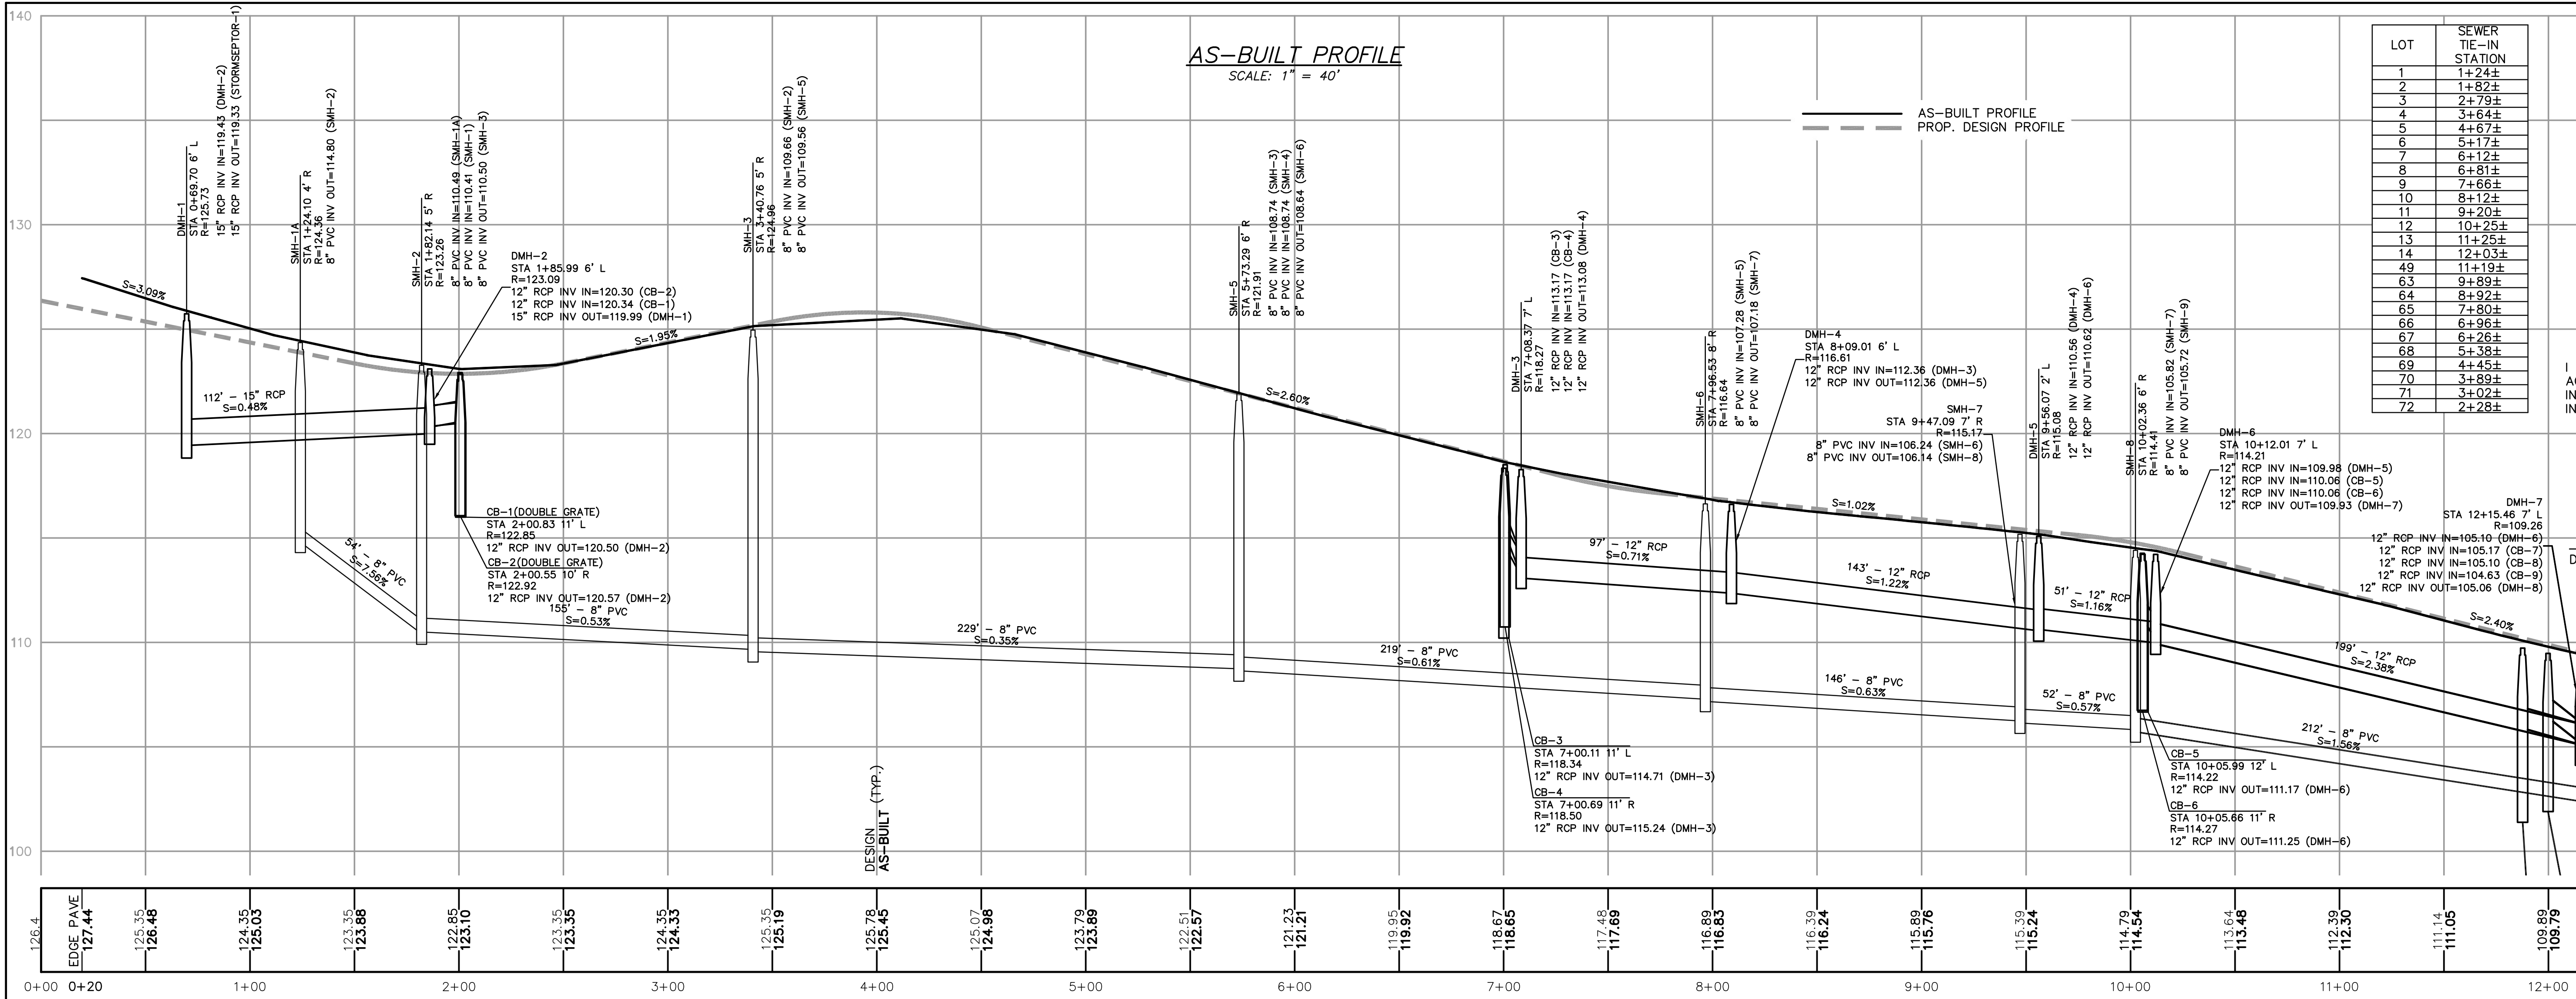

LOT	SEWER TIE-IN STATION
1	1+24±
2	1+82±
3	2+79±
4	3+64±
5	4+67±
6	5+17±
7	6+12±
8	6+81±
9	7+66±
10	8+12±
11	9+20±
12	10+25±
13	11+25±
14	12+03±
49	11+19±
63	9+89±
64	8+92±
65	7+80±
66	6+96±
67	6+26±
68	5+38±
69	4+45±
70	3+89±
71	3+02±
72	2+28±


FOR REGISTRY USE ONLY

I CERTIFY THAT THIS PLAN IS A TRUE AND ACCURATE REPRESENTATION OF THE SUBDIVISION INFRASTRUCTURE AND TOPOGRAPHY INCLUDING INVERTS, ELEVATIONS AND LOCATIONS.

DATE: PROFESSIONAL LAND SURVEYOR

I CERTIFY THAT THIS PLAN HAS BEEN PREPARED IN CONFORMANCE WITH THE RULES AND REGULATIONS OF THE REGISTERS OF DEEDS.

DATE: PROFESSIONAL LAND SURVEYOR

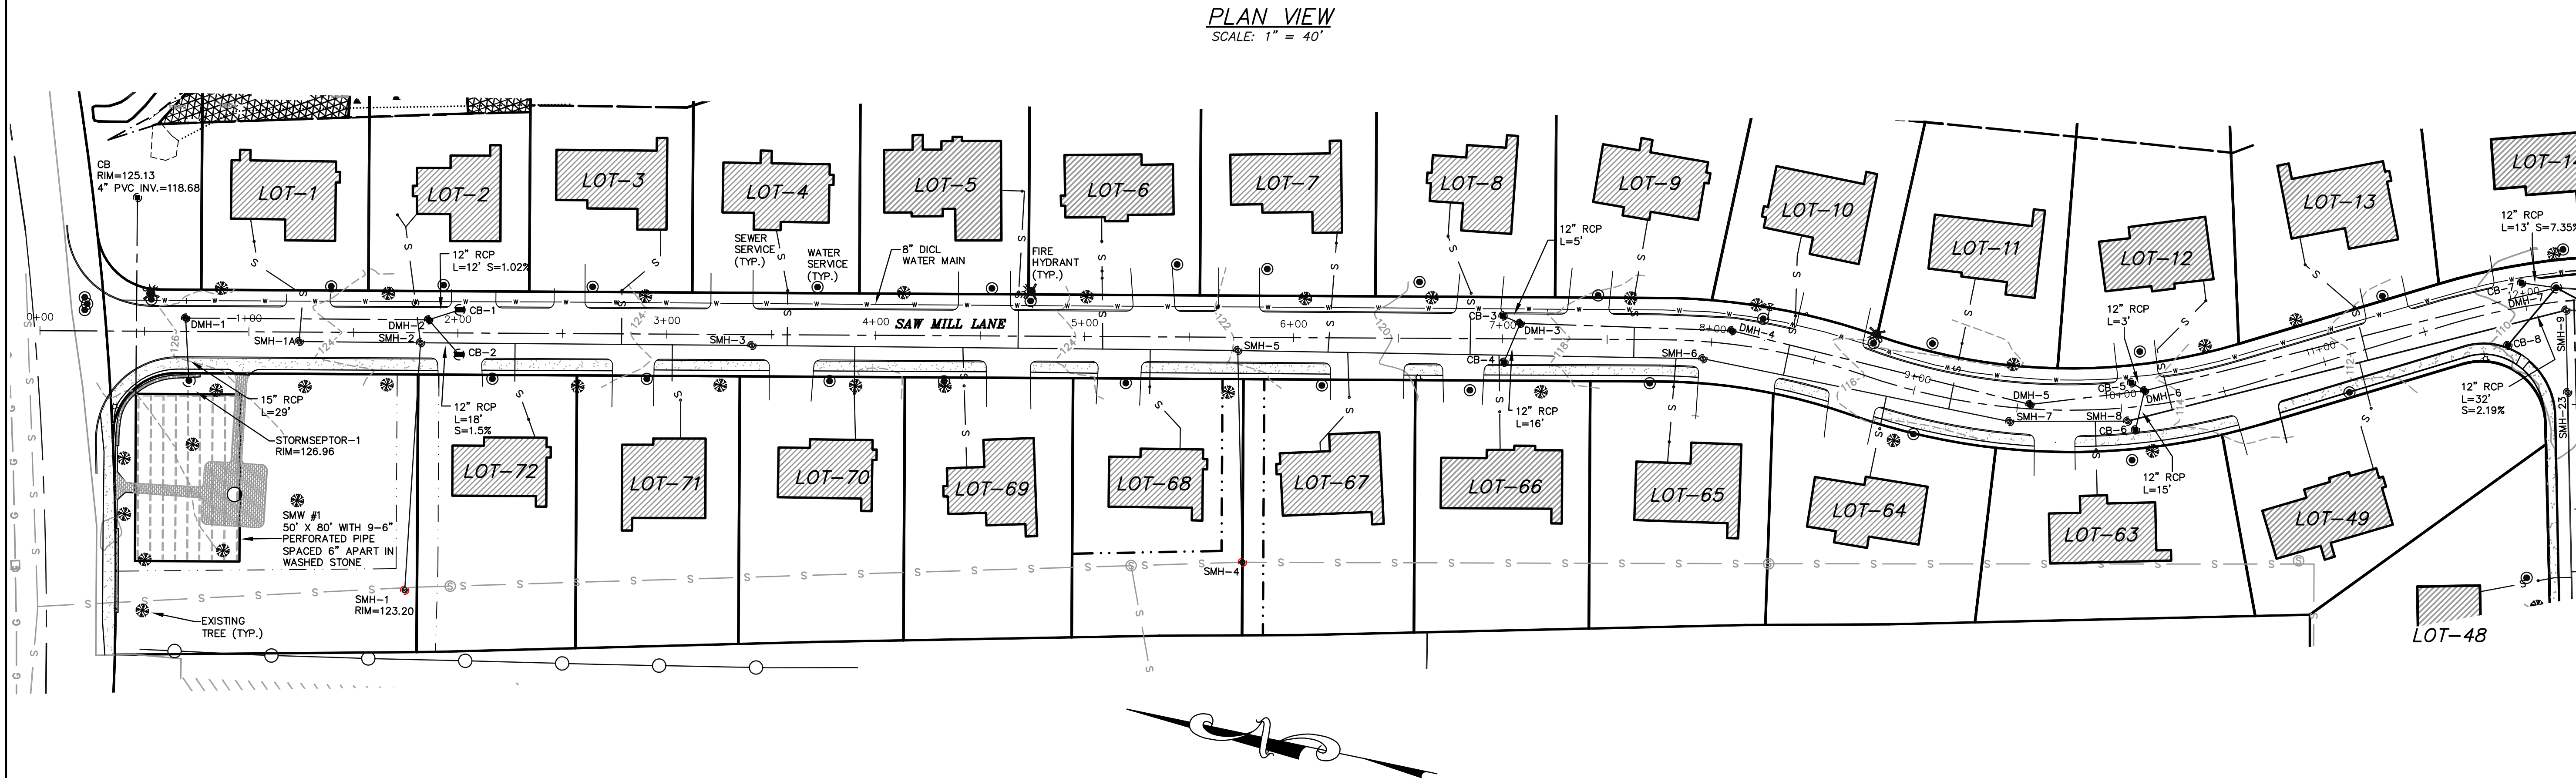

OWNER &
APPLICANT


STONEBRIDGE BUILDERS &
DEVELOPERS
C/O MUHAMMAD ITANI
32 NORFOLK AVENUE
S. EASTON, MA 02375

REVISIONS

NO.	DATE	DESCRIPTION
1	9/2/16	REVIEW ENGINEER COMMENTS
2	11/14/16	ADD SEWER TIE-IN STATIONS

ROADWAY AS-BUILT
PLAN



"MAPLEWOOD ESTATES"
A DEFINITIVE SUBDIVISION
IN
ROCKLAND
MASSACHUSETTS

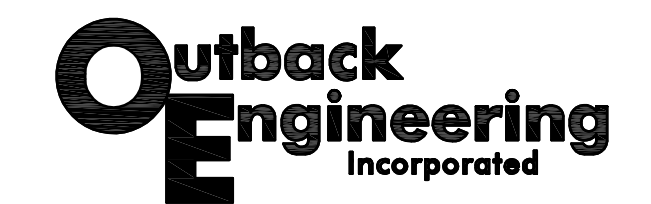

165 EAST GROVE STREET
MIDDLEBOROUGH, MA 02346
TEL: (508)-946-9231

DRAWN BY: T.E.M. CHECKED BY: J.A.Y.
6/28/16 PROJECT No. 1885A
1885A-ROADAB.DWG SHEET 1 OF 4

0' 40' 80' 120'
SCALE: 1"=40'

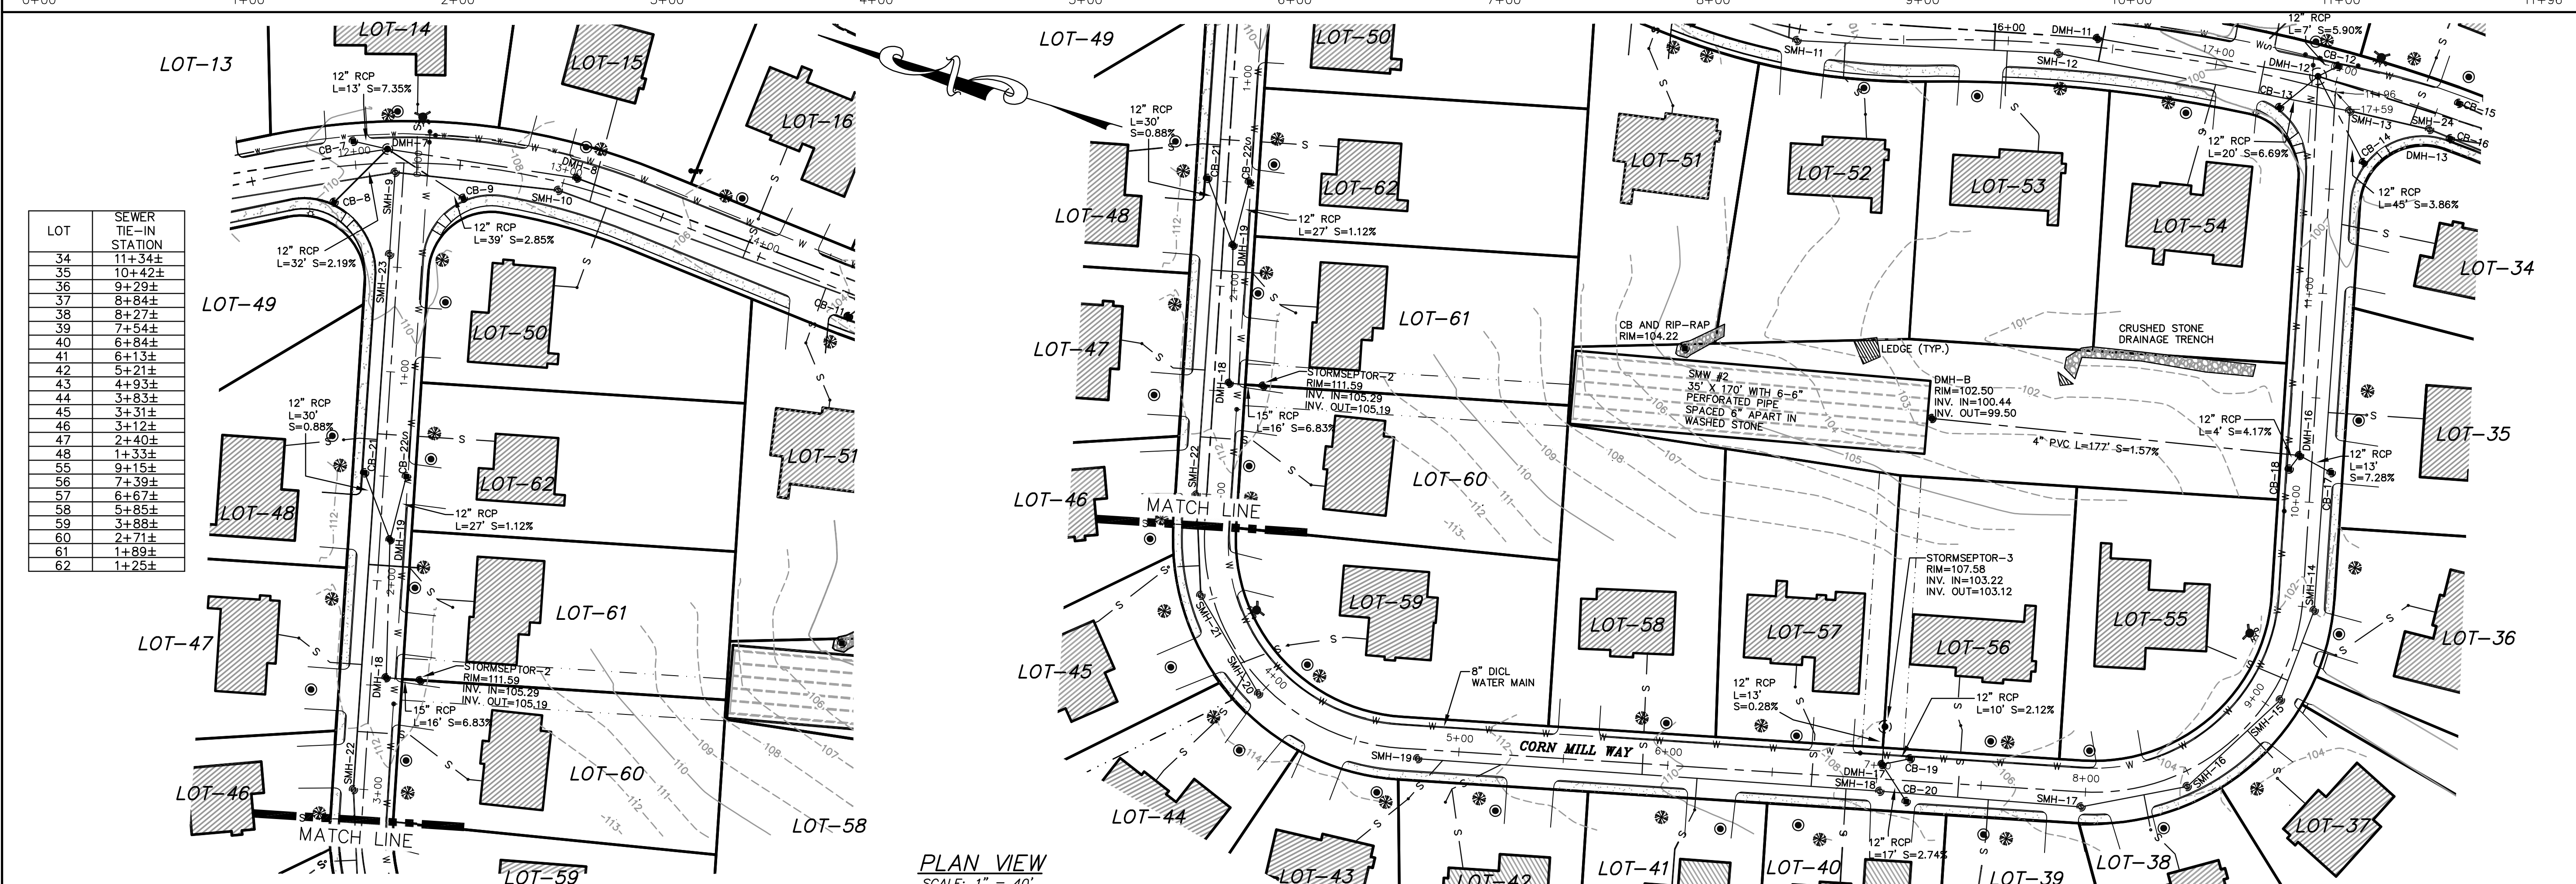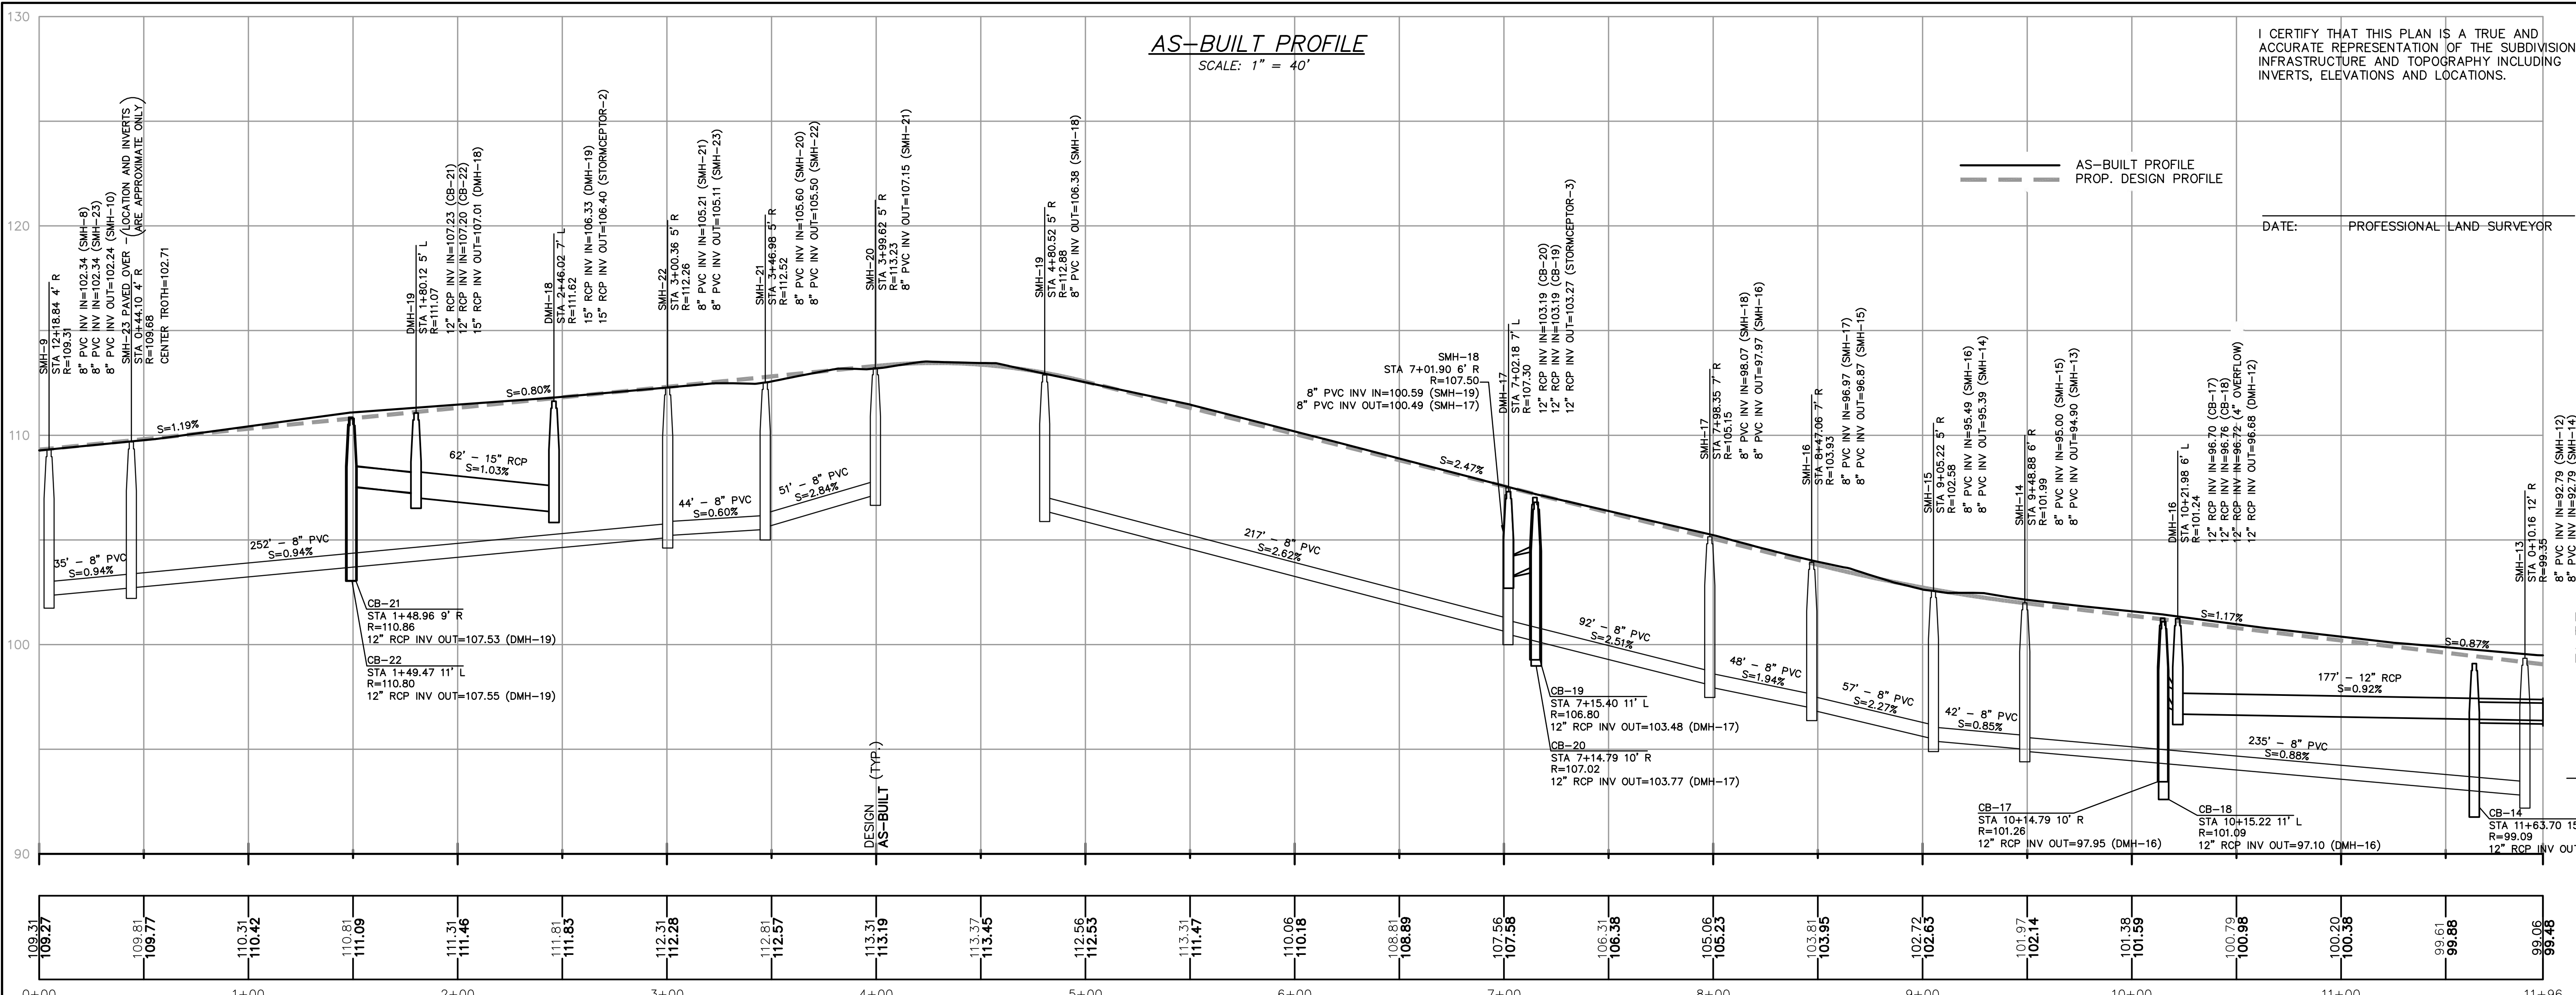

OWNER & APPLICANT
STONEBRIDGE BUILDERS & DEVELOPERS
C/O MUHAMMAD ITANI
32 NORFOLK AVENUE
S. EASTON, MA 02375

REVISIONS

NO.	DATE	DESCRIPTION
1	9/2/16	REVIEW ENGINEER COMMENTS
2	11/14/16	ADD SEWER TIE-IN STATIONS


ROADWAY AS-BUILT PLAN
"MAPLEWOOD ESTATES"
A DEFINITIVE SUBDIVISION
IN
ROCKLAND
MASSACHUSETTS

Outback Engineering Incorporated


165 EAST GROVE STREET
MIDDLEBOROUGH, MA 02346
TEL: (508)-946-9231

DRAWN BY: T.E.M. CHECKED BY: J.A.Y.
6/28/16 PROJECT No. 1885A
1885A-ROADAB.DWG SHEET 3 OF 4

0' 40' 80' 120'
SCALE: 1" = 40'

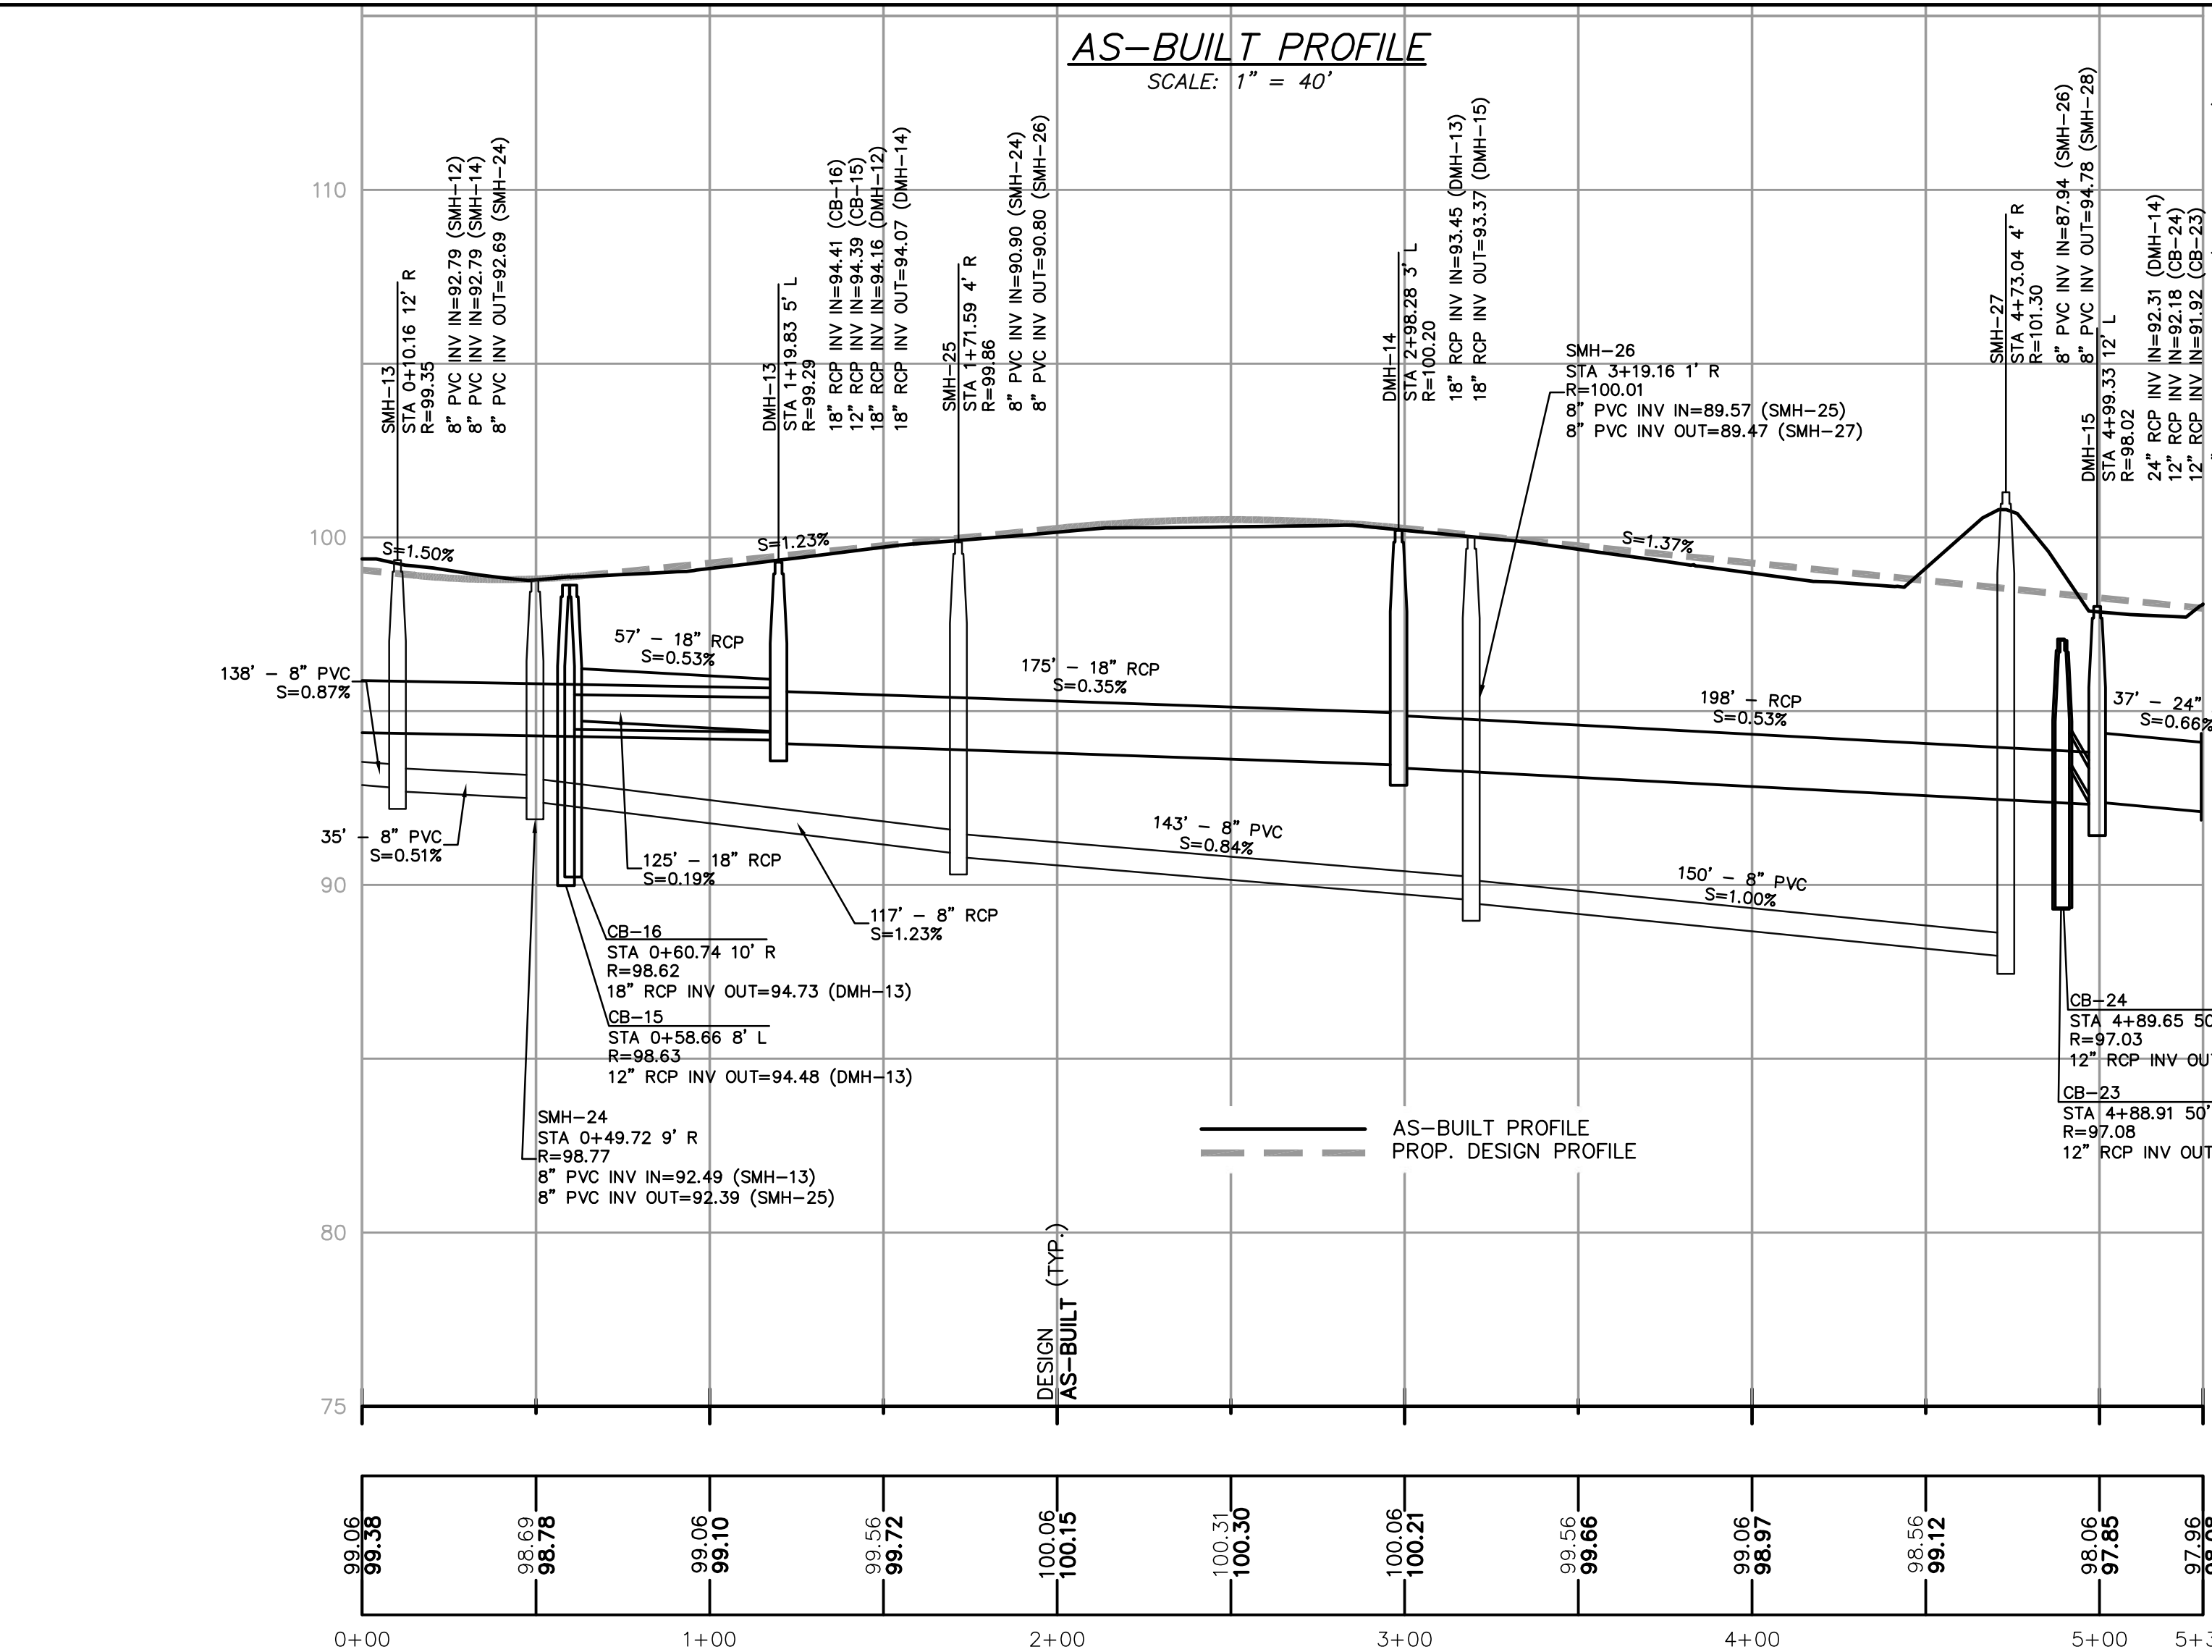

SEE CUL-DE-SAC
GRADING DETAIL

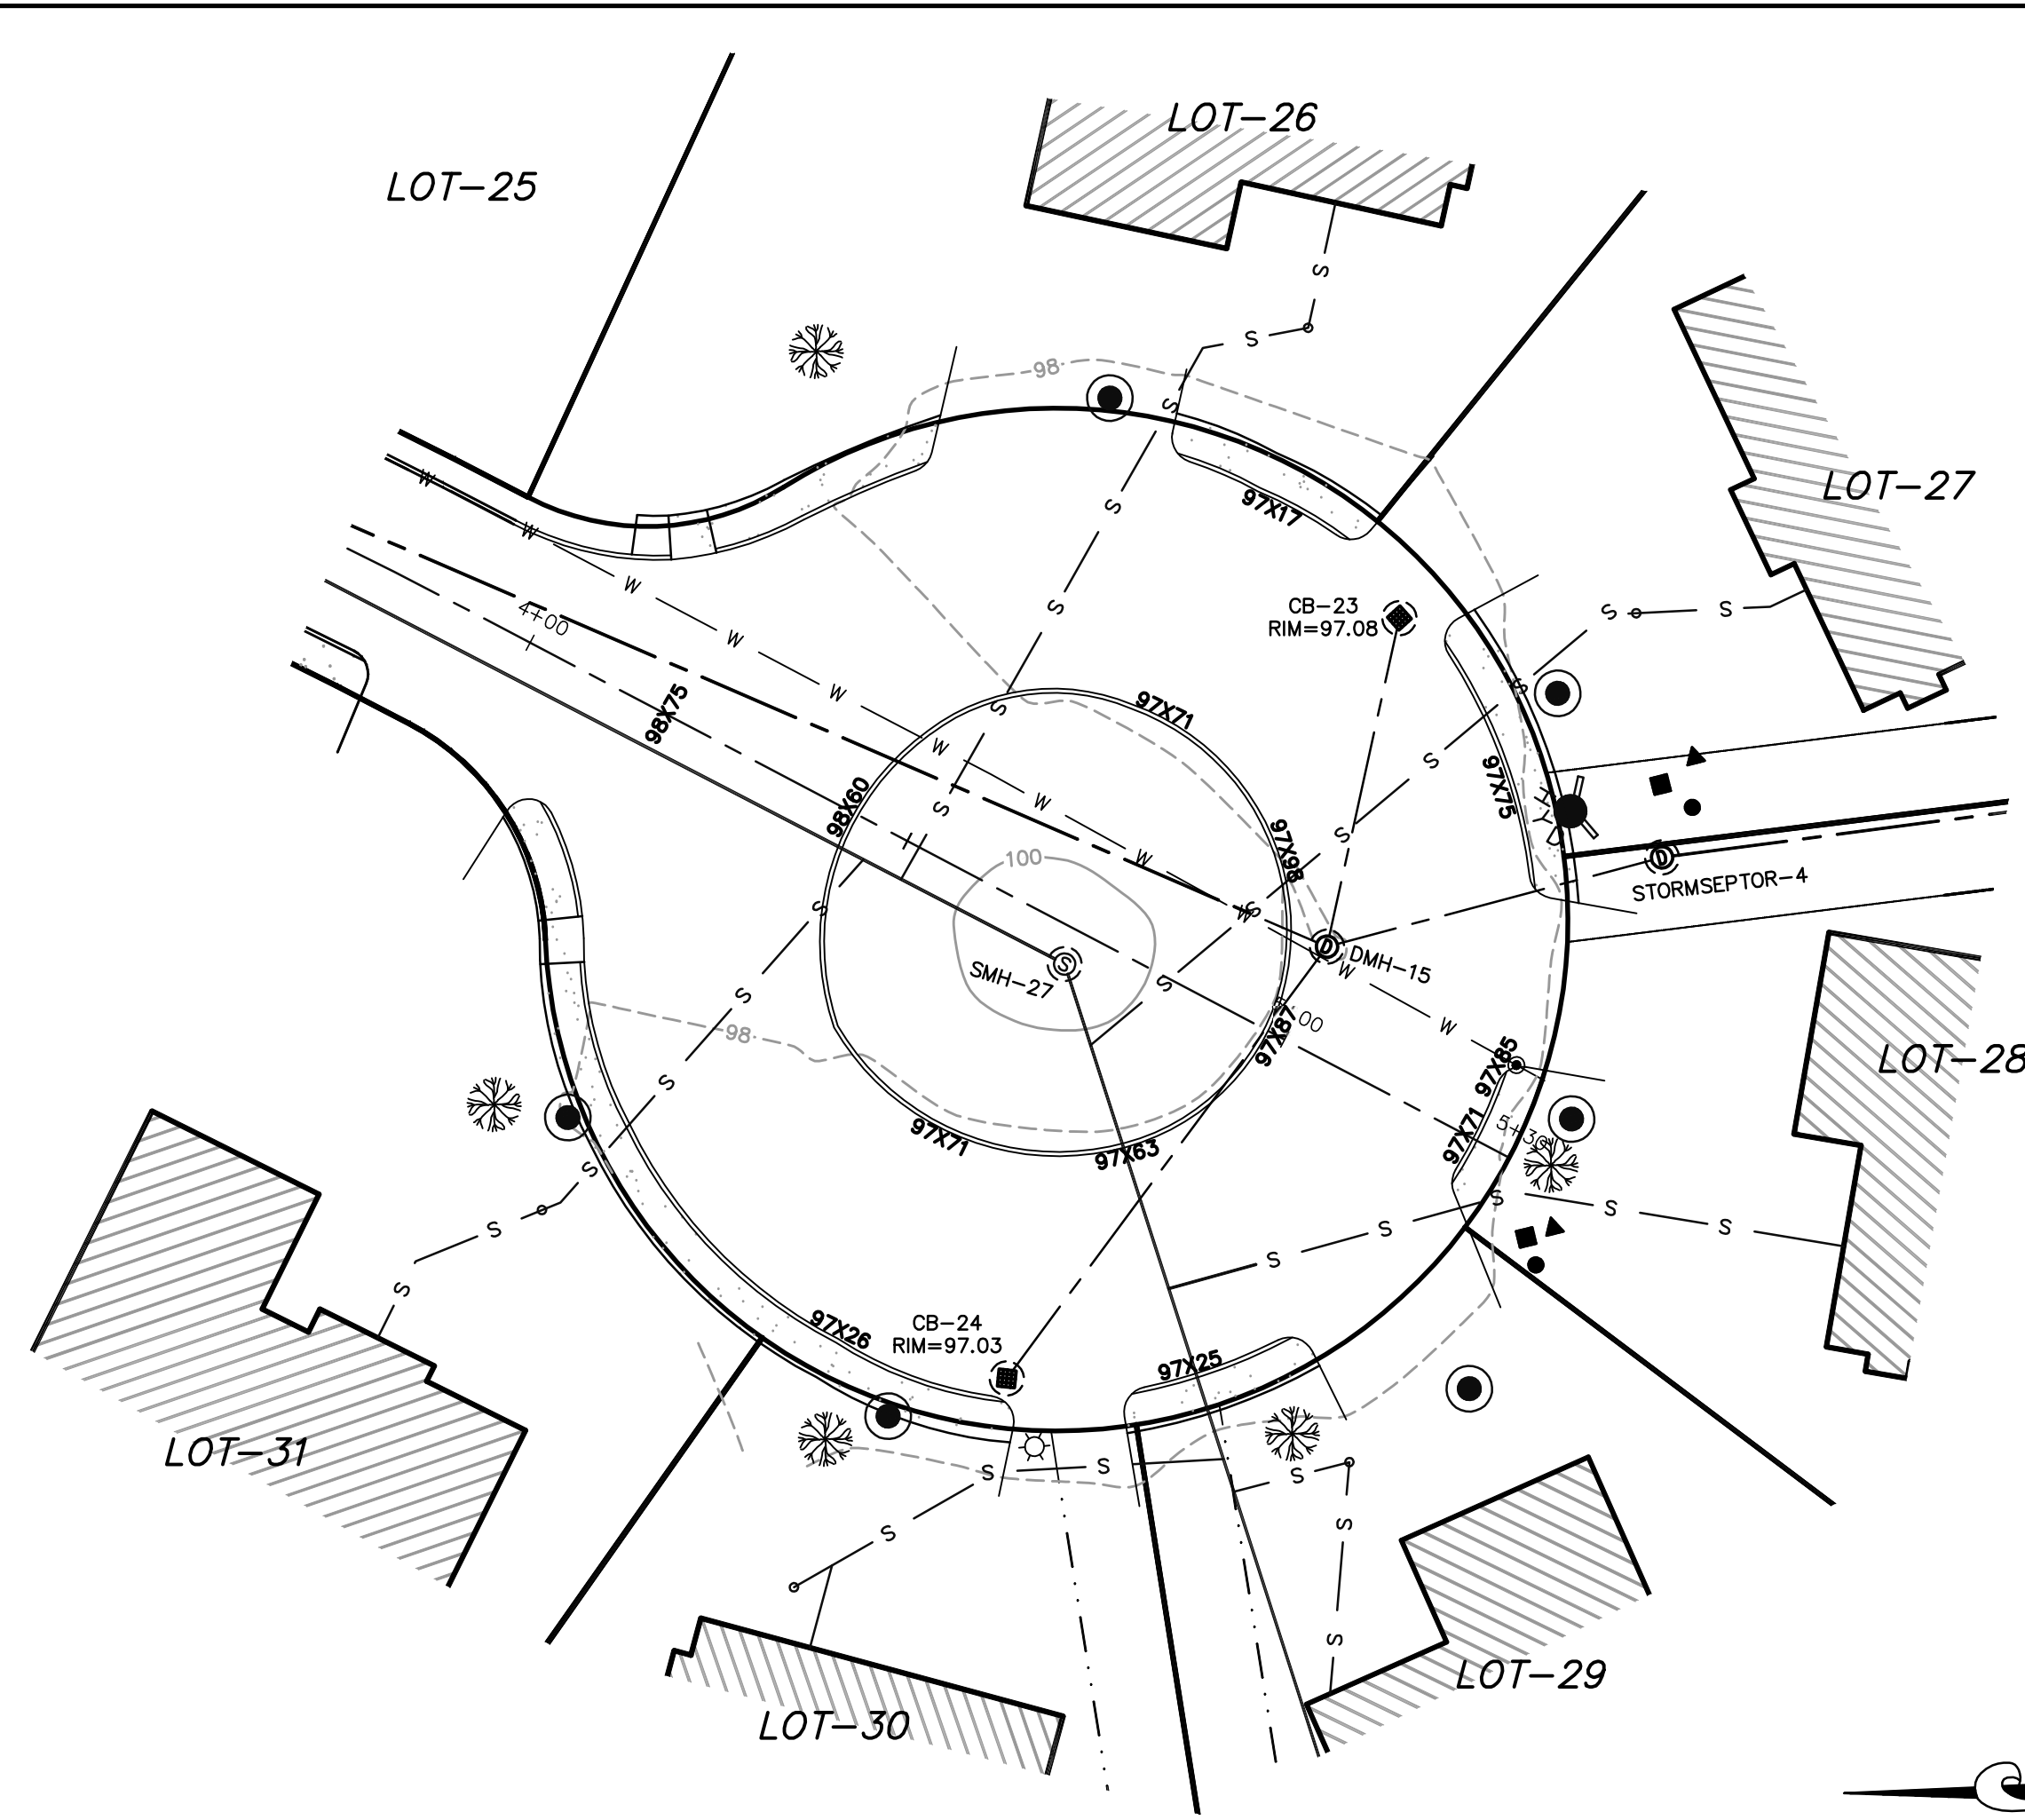


FOR REGISTRY USE ONLY

I CERTIFY THAT THIS PLAN IS A TRUE AND
ACCURATE REPRESENTATION OF THE SUBDIVISION
INFRASTRUCTURE AND TOPOGRAPHY INCLUDING
INVERTS, ELEVATIONS AND LOCATIONS.

DATE: PROFESSIONAL LAND SURVEYOR

I CERTIFY THAT THIS PLAN HAS BEEN
PREPARED IN CONFORMANCE WITH THE RULES
AND REGULATIONS OF THE REGISTERS OF
DEEDS.

DATE PROFESSIONAL LAND SURVEYOR

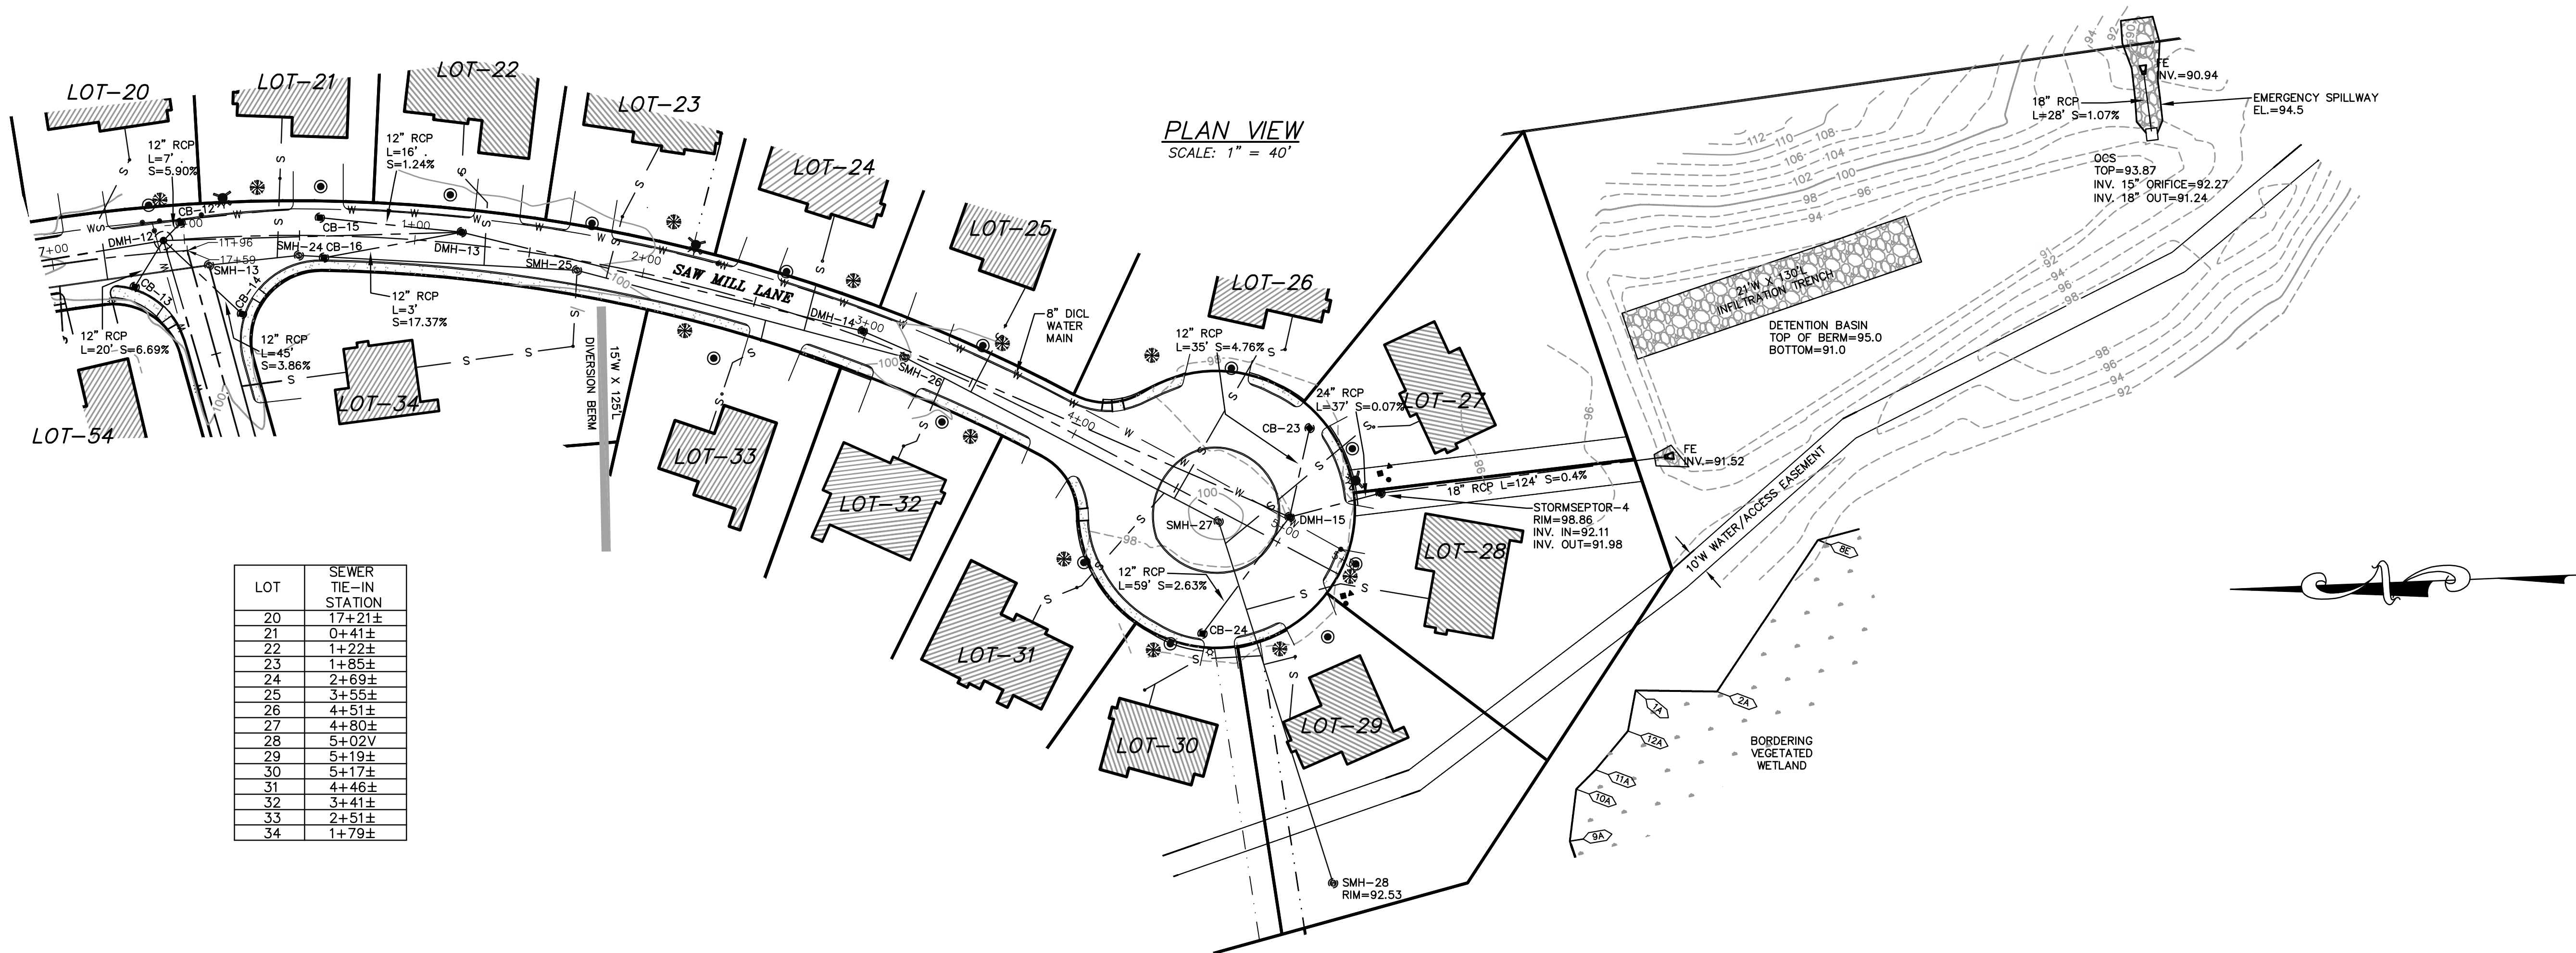

LOT	SEWER TIE-IN STATION
20	17+21±
21	0+41±
22	1+22±
23	1+85±
24	2+69±
25	3+55±
26	4+51±
27	4+80±
28	5+02±
29	5+19±
30	5+17±
31	4+46±
32	3+41±
33	2+51±
34	1+79±

**OWNER &
APPLICANT**


STONEBRIDGE BUILDERS &
DEVELOPERS
C/O MUHAMMAD ITANI
32 NORFOLK AVENUE
S. EASTON, MA 02375

REVISIONS

NO.	DATE	DESCRIPTION
1	9/2/16	REVIEW ENGINEER COMMENTS
2	11/14/16	ADD SEWER TIE-IN STATIONS

ROADWAY AS-BUILT
PLAN

"MAPLEWOOD ESTATES"
A DEFINITIVE SUBDIVISION
IN
ROCKLAND
MASSACHUSETTS

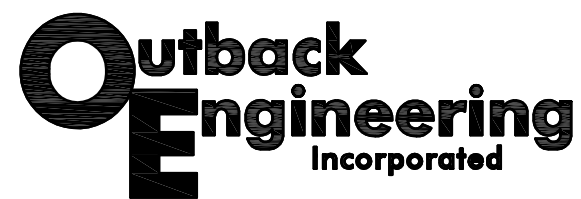

165 EAST GROVE STREET
MIDDLEBOROUGH, MA 02346
TEL: (508)-946-9231

DRAWN BY: T.E.M.	CHECKED BY: J.A.Y.
6/28/16	PROJECT No. 1885A
1885A-ROADAB.DWG	SHEET 4 OF 4

